

4439 Keeler Ave ADU
4439 Keeler Ave.
San Diego, CA 92113



Revision Dates	
1	08.15.24
2	01.01.25

SHEET TITLE
Site Plan

Drawing Date
08.24.26

Check By


Drawn By
FRANCIS N.

Scale
As indicated

Job Number
081623

Sheet Number

A02

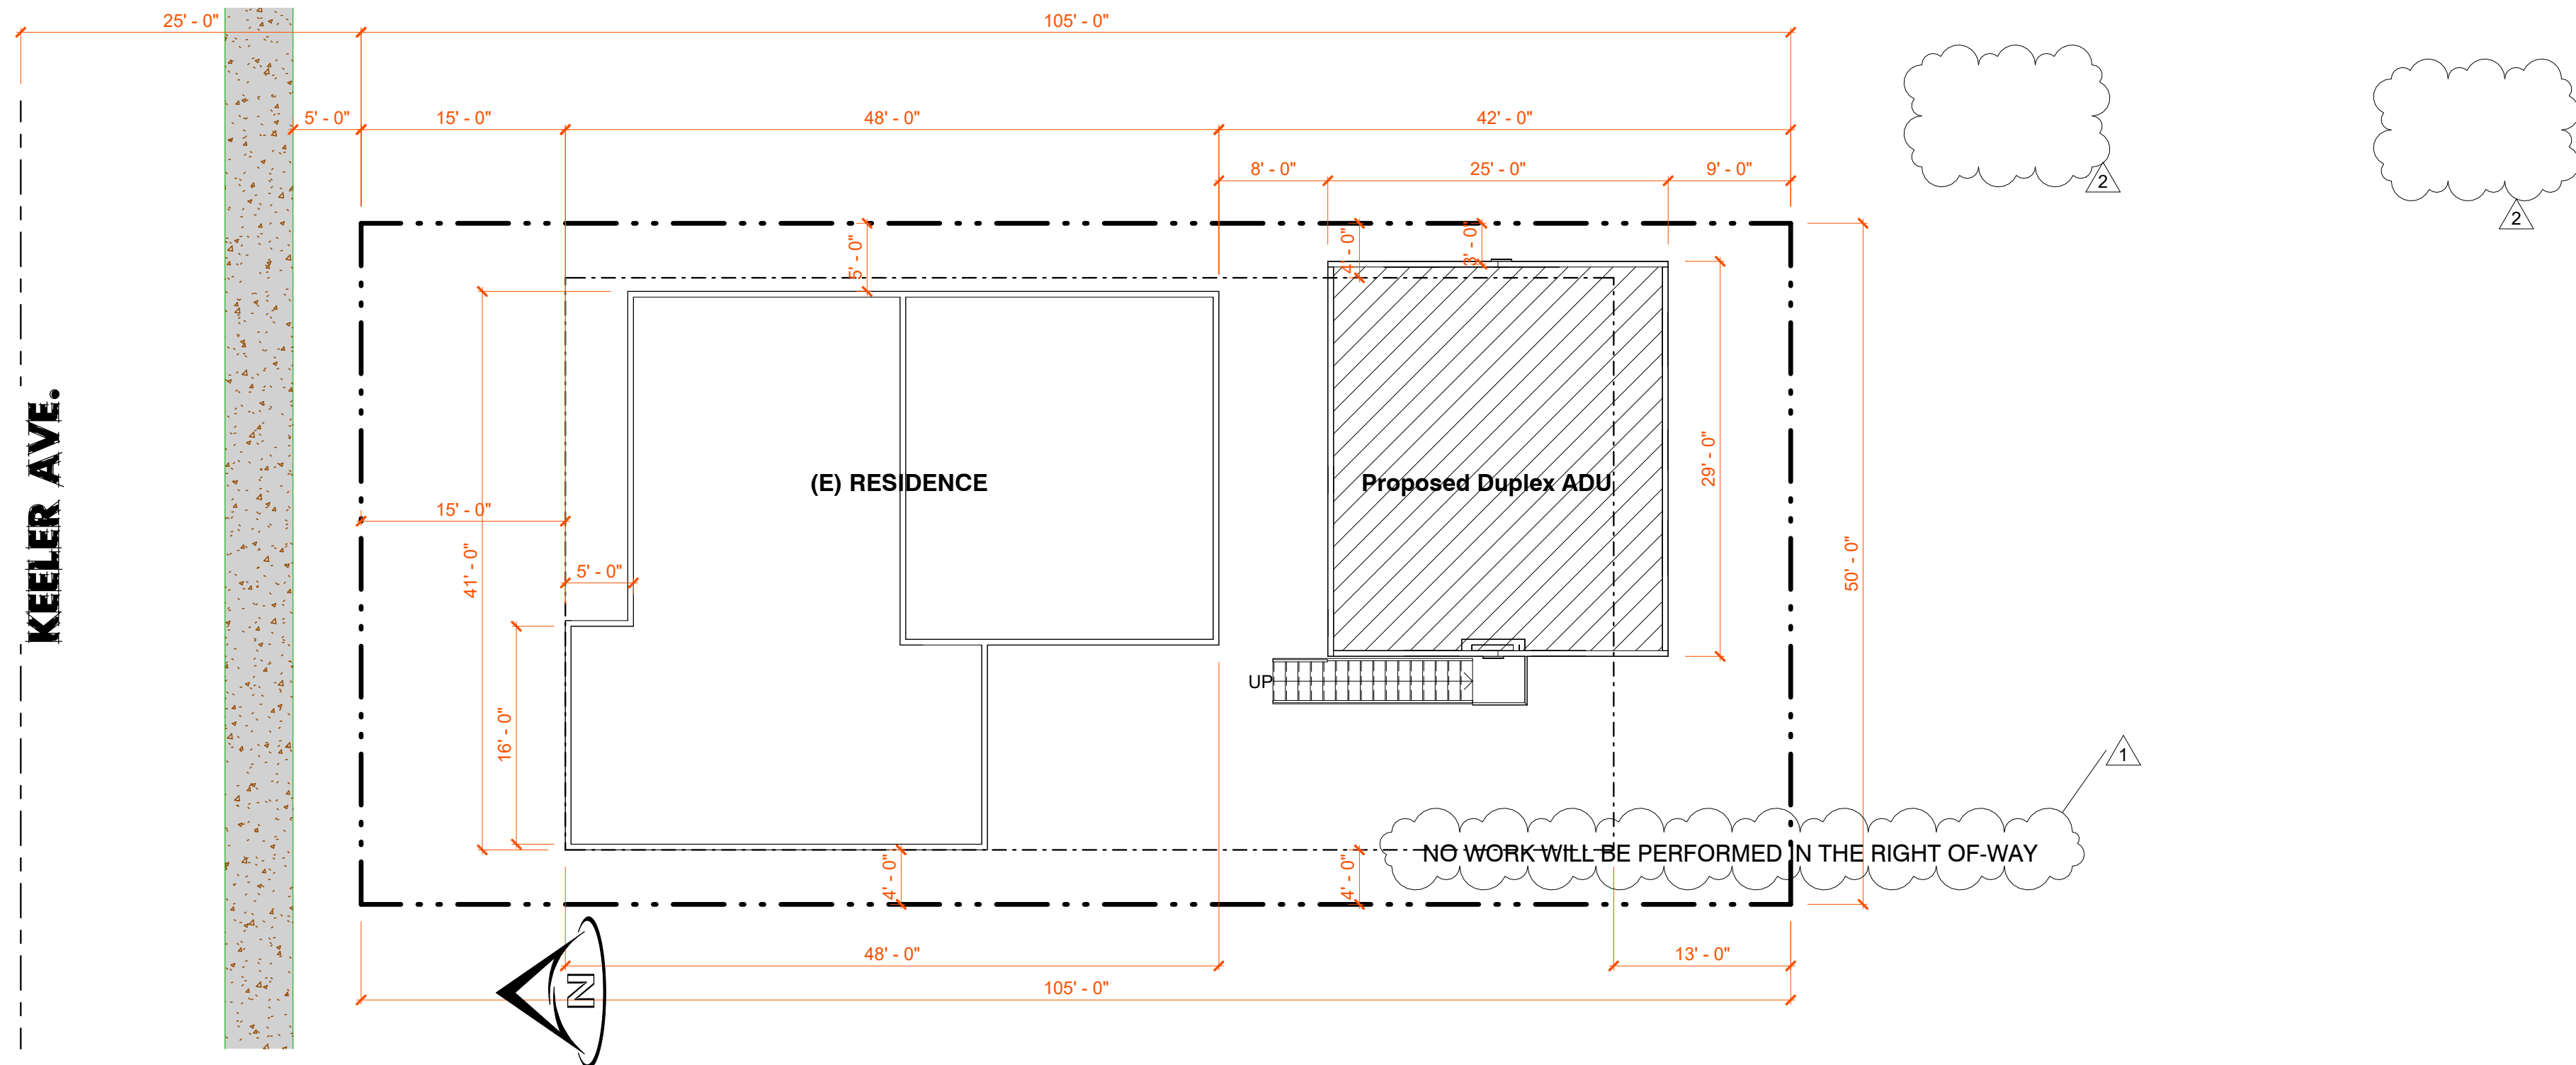

STORM WATER QUALITY NOTES
CONSTRUCTION BMP'S

THIS PROJECT SHALL COMPLY WITH ALL REQUIREMENTS OF THE STATE PERMIT:
CALIFORNIA REGIONAL WATER QUALITY CONTROL BOARD, SAN DIEGO REGION, AND THE
CITY OF SAN DIEGO LAND DEVELOPMENT CODE

NOTES 1-6 BELOW REPRESENT KEY MINIMUM REQUIREMENTS FOR CONSTRUCTION BMP'S

1. SUFFICIENT BMP'S MUST BE INSTALLED TO PREVENT SILT, MUD, OR OTHER CONSTRUCTION DEBRIS FROM BEING TRACKED INTO ADJACENT STREET(S) OR STORM WATER CONVEYANCE SYSTEMS DUE TO CONSTRUCTION VEHICLES OR ANY OTHER CONSTRUCTION ACTIVITY. THE CONTRACTOR SHALL BE RESPONSIBLE FOR CLEANING ANY SUCH DEBRIS THAT MAY BE IN THE STREET AT THE END OF EACH WORK DAY OR AFTER A STORM EVENT THAT CAUSE A BREACH IN THE INSTALLED CONSTRUCTION BMP'S.

2. ALL STOCK PILES OF UNCOMPACTED SOIL AND/OR BUILDING MATERIALS THAT ARE INTENDED TO BE LEFT UNPROTECTED FOR A PERIOD GREATER THAN SEVEN CALENDAR DAYS ARE TO BE PROVIDED WITH EROSION AND SEDIMENT CONTROLS. SUCH SOIL MUST BE PROTECTED EACH DAY WHEN THE PROBABILITY OF RAIN IS 40% OR GREATER.

3. A CONCRETE WASHOUT SHALL BE PROVIDED ON ALL PROJECTS WHICH PROPOSE THE CONSTRUCTION OF ANY CONCRETE IMPROVEMENTS THAT ARE

4. ALL EROSION/ SEDIMENT CONTROL DEVICES SHALL BE MAINTAINED IN WORKING ORDER AT ALL TIMES

5. ALL SLOPES THAT ARE CREATED OR DISTURBED BY CONSTRUCTION ACTIVITY MUST BE PROTECTED AGAINST EROSION AND SEDIMENT TRANSPORT AT ALL TIMES

6. THE STORAGE OF ALL CONSTRUCTION MATERIALS AND EQUIPMENT MUST BE PROTECTED AGAINST ANY POTENTIAL RELEASE OF POLLUTANTS INTO THE ENVIROMENT.

"ALL STORMWATER RUNOFF FROM PROPOSED AND/OR REPLACED IMPERVIOUS AREAS SHALL BE ROUTED TO PERVIOUS SURFACES OR LANDSCAPING PRIOR TO REACHING THE PUBLIC DRAIN SYSTEM

GRADING QUATITIES:

CUT QUANTITIES (CYD) : 5
FILL QUANTITIES (CYD) : 5
IMPORT/EXPORT (CYD) : 0
MAX. CUT DEPTH (FT) : 2
MAX FILL DEPTH (FT) : 2

TOTAL DISTURBANCE AREA: __1900 SF__

PROPOSED AMOUNT OF IMPERVIOUS AREA: __1,783 SF__

TOTAL PLUMBING FIXTURE CALCULATION

EXISTING RESIDENCE (BLDG-1):

(1) Lavatory
(1) Kitchen Sink
(1) Shower
(1) Water Closet
(1) Clothes Washer

PROPOSED ADU (BLDG-2) - UNIT 1, 1ST FLOOR:

(2) Lavatory
(1) Kitchen Sink
(1) Shower
(1) Water Closet
(1) Clothes Washer

PROPOSED ADU (BLDG-2) - UNIT 2, 2ND FLOOR:

(2) Lavatory
(1) Kitchen Sink
(1) Shower
(1) Water Closet
(1) Clothes Washer

KEYNOTES:

- EXISTING DRIVEWAY
- EXISTING SIDEWALK
- EXISTING STREET CURB
- EXIST. CONC.
- PROPOSED GAS METER LOCATION FOR NEW ADU
- PROPOSED ELECTRICAL METER LOCATION FOR NEW ADU
- EXISTING 1" WATER METER LOCATION
- DOWN SPOUT ROOF DRAIN LOCATION
- EXISTING TREES
- NEW CONCRETE
- EXISTING LANDCAPING AREA
- PROPOSED STREET TREES
- PROPOSED TREES

PER CITY OF SAN DIEGO MUNICIPAL CODE SECTION 12.0104, 43.010, 129.0104(A)(4), AND 142.0220, PERMITS ARE REQUIRED TO BE INSPECTED BY CITY INSPECTION STAFF TO ENSURE COMPLIANCE WITH ISSUED CONSTRUCTION PERMIT. THIS INCLUDES, BUT NOT LIMITED TO, STORMWATER COMPLIANCE INSPECTION REQUIREMENTS ASSOCIATED WITH EACH PERMIT

LEGEND

— PL —	PROPERTY LINE
- - - - -	SET BACK LINE
- - - 182 - - -	EXISTING COUNTOUR LINE
=====	EXISTING LINE OF FENCE
— FR — FR — FR —	FIBER ROLLS SC-5
→	DRAIN PATTERN
[Pattern]	EXISTING LANDSCAPING AREA
[Pattern]	EXISTING CONC. DRIVE WAY
[Pattern]	NEW CONC.

THIS PROJECT ASSUMES A SOIL BEARING PRESSURE OF 1500PSI

THE STRUCTURE(S) WILL BE LOCATED ENTIRELY ON UNDISTURBED NATIVE SOIL. IF THE BUILDING INSPECTOR SUSPECTS FILL, EXPANSIVE SOILS OR ANY GEOLOGIC INSTABILITY BASED UPON OBSERVATION OF THE FOUNDATION EXCAVATION, A SOILS OR GEOLOGICAL REPORT, AND RESUBMITTAL OF PLANS TO PLAN CHECK TO VERIFY THAT THE REPORT RECOMMENDATIONS HAVE BEEN INCORPORATED, MAY BE REQUIRED.

SIGNATURE OWNER *John*